






400 WACB 0103-3	↓	AC
DWG NO	2H	REA

 

19							18							17						
REV	SHT	ZONE	ITEM	DESCRIPTION	DATE	APPROV	REV	SHT	ZONE	ITEM	DESCRIPTION	DATE	APPROV							
F	1	BB-F	1	4000 (4) WAGON DECKS TO REFLECT AS-BUILT CONFIG.	10/01/2012	JRS./JL/ SFLC/DAWG	F	5			PLAN UPDATED TO SUIT LATEST REVISION OF GENERAL ARRANGEMENT PLANS. NMRCS 7723									
U																				
1	2C	1		THIS REVISION INCORPORATES THE SEATEL VSATCOMSYS.			G	7			ADDED MOBILE DTE HYDRAULIC OIL TANK 797 (3-189-1-F) AND 2110 HYDRAULIC OIL TANK (3-186-1-F) IN (2-182-0-F) ROLL STABILIZATION TANK OV.									
2	28E, 59C, 153E	2		ADDED SEATEL VSAT 6009 ANTENNA.	6/18/12	RRR/s/ ESU	H	2			ADDED ADF SENSE ANTENNA @ ALOFT CONNING STATION TO OUTBOARD PROFILE.									
4																				
5	75C, D	3		ADDED PP, SKVA XFMR & VSAT RACK.		JRL-ATG														
V																				
2, 4, 10	28E, 59B, 153E	1		THIS REVISION UPDATES REV U DUE TO REVISED SEATEL VSATCOMSYS ANTENNA LOCATION.	1/15/13	RRR/s/ ESU	J	4			1. CHANGED SPACE 1-119-2-D UNASSIGNED TO SCAMP RM.									
5	75C	2		REVISED SEATEL 6009 ANTENNA LOCATION FROM CL ON FRAME 185 TO FRAME 180, 117" STABOARD OF CL.							2. ADDED RAYCAS-V-IND. & DATA LOGGER PRINTER IN PILOT HOUSE.									
W																				
2, 4, 10	24E, 57C, 157E	1		THIS REVISION INCORPORATES THE IRIUM SECURE SATELLITE SYSTEM.	4/12/13	WGT/s/					3. DELETED DDP-516, ASR-35, SPERRY CAS COMPUTER & EQUIPMENT RACK IN CHART ROOM.									
Y																				
1	2-D	1		ADDED REFERENCE #2.	6/11/13	SPM/s/ CG Yard	K	2			REVISED PLAN TO SUIT CHANGES DUE TO ACCOMPLISHMENT OF SCIENTIFIC UP-GRADE.	1/30/92	R.Y. J.C.L. J.B.S.							
8	121-C	2		REVISED DESCRIPTION OF TRANSDUCER SPACE FROM "AN/UQN-4 TRANSDUCER SP 6-63-2-Q"																
1	2-C	3		THIS PORTION OF REVISION ACCOMPLISHED IAW PROJECT B1132 TO DOCUMENT THE REPLACEMENT OF THE A1178 KU BAND ANTENNA WITH THE SEATEL 6009-33 ONBOARD THE POLAR STAR.																
2	25-E, 29-E, 58-G, 60-C, 152-E, 156-E	4		REVISED DESCRIPTION OF KU BAND ANTENNA FROM "A1178 KU BAND ANTENNA WITH THE SEATEL 6009-33 ONBOARD THE POLAR STAR."			N				1. UPDATED ACCOMMODATIONS LIST									
AA											2. MODIFIED HULL MARKINGS & FLIGHT DECK									
2, 10	28E, 153E, 153E	1		THIS REVISION UPDATES THE SEATEL VSATCOM SYSTEM (REV U).	9/13/13	DC/s/ ESU					3. ADDED CHIEF SCIENTIST SR 01-74-4-L, OCEANOGRAPHIC WINCH RM 01-106-2-Q, MODIFIED HELD CONFIG. 01 LVL & REMOVED OBSOLETE HELD 02 LVL.	6/14/94	R.W.N.							
AB																				
1	1-C	1		REVISION TO SUIT CHANGES DUE TO THE REPLACEMENT OF THE TWO 3 TON AND AFT PORT AND STBD 15 TON CRANES ON THE COG POLAR STAR.	9/24/13	FWD /S/ SFLC-ESD-NAME-NASC	P				4. ADDED ENGINEER'S STORE RM 1-E-1-A, CREW WR, WC, & SHR (FEMALE) 2-44-3-L, MODIFIED DENTAL OPER RM 1-105-1-L TO BARBER SHOP 1-105-1-Q.									
2	24-D	2		ADDED REFERENCES 4 AND 5.							ENGINEER STYM 2-104-2-A TO ENLISTED SR 2-104-2-L, BARBER SHOP 2-69-1-D TO ENLISTED SR 2-69-1-L & CREW BAG RM 2-137-1-A TO CREW WR, WC & SHR 2-137-1-L.									
3	40-D	3		FWD 3 TON CRANE REPLACED BY ALLIED SYSTEMS CO. 3 TON CRANE TB60-60. SEE REFERENCE 4.																
4	72-C	4		AFT 15 TON CRANE REPLACED BY ALLIED SYSTEMS CO. 15 TON CRANE K260-10. SEE REFERENCE 5.																
5	157-D	5		REVISED COMPARTMENT 1-E-0-Q-E TO REFLECT NEW HPU SYSTEM RM PANEL IN ACCORDANCE WITH REFERENCE 4.																
6	88-G	6		REVISED COMPARTMENT 2-E-0-A TO REFLECT NEW HPU SYSTEM EQUIPMENT IN ACCORDANCE WITH REFERENCE 4.																
7	108-E	7		REVISED COMPARTMENTS 3-143-3-0 AND 3-143-5-0 TO REFLECT REPLACEMENT OF CENTRAL HYDRAULIC SYSTEM WITH NEW ALLIED SYSTEMS CO. HPU SYSTEM IN ACCORDANCE WITH REFERENCE 5.																
8	77-B	8		DELETED PORTION OF 15 TON AFT CRANE OVERHANGING HANGAR TOP CRANE SHAULE AND PIPE DUE TO REPLACEMENT BY NEW CRANE. SEE REFERENCE 5.																
9	73-B	9																		
10	153-D	10																		
AC																				
3	45-B	1		REVISED IAW CG-22 NO. 13902 "COMPARTMENT NUMBER INCORRECT" & PROJECT 75H03 "WAGB PROJECT & INDUSTRY SUPPORT".	5/4/16	L. FALCONE CG 1980														

U.S. COAST GUARD HEADQUARTERS WASHINGTON, D.C. 20593			
NAVAL ENGINEERING DIVISION			
400' WAGB			
BOOKLET OF GENERAL PLANS			
OUTBOARD PROFILE			
SIZE FROM CASE NO.		U.S.G.C. DRAWING NO.	
H 81340		400 WAGB 0103-3 AC	
SCALE 1/8"=1'-0"		19.6 5291	
SHEET		2	

19				18				17			

U.S. COAST GUARD HEADQUARTERS WASHINGTON, D.C. 20563

NAVAL ENGINEERING DIVISION

400' WAGB

BOOKLET OF GENERAL PLANS


OUTBOARD PROFILE

DATE FROM CASE NO. H 81340 U.S.C.G. DRAWING NO. 400 WAGB 0103-3 REV. 1

SCALE 1/8"=1'-0" 19.6 SPT SHEET 2



400 WAGB 0103-3  
DWG NO.

 

INBOARD PROFILE  
400 WAGB 0103-3  
PLATE 4 OF 17

REVISIONS				DATE	APPROV
REV	SHT	ZONE	ITEM		

U.S. COAST GUARD HEADQUARTERS WASHINGTON, D.C. 20563  
NAVAL ENGINEERING DIVISION  
400' WAGB  
BOOKLET OF GENERAL PLANS  
INBOARD PROFILE


SIZE	FROM CASE NO.	U.S.C.G. DRAWING NO.	REV
H	81340	400 WAGB 0103-3	AC
SCALE	1/8"=1'-0"	19.6.527	SHEET 3 OF 19

DWG NO. 400 WAGB 0103-3  
SH 3 REV AB



															DWG NO 400 WAGB 0103-3		SH 4	REV AB		
															H 81340		400 WAGB 0103-3		AB	
															SCALE 1/8"=1'-0"		10.6 SQFT		SHEET 1	
64	63	62	61	60	59	58	57	56	55	54	53	52	51	50	49					



 

REVISIONS					DATE	APPROV
REV	SHT	ZONE	ITEM	DESCRIPTION		

U.S. COAST GUARD HEADQUARTERS WASHINGTON, D.C. 20593			
NAVAL ENGINEERING DIVISION			
400' WAGB			
BOOKLET OF GENERAL PLANS			
01 & 02 LEVELS			
SIZE	FROM CASE NO.	U.S.C.G. DRAWING NO.	REV
H	81340	400 WAGB 0103-3	AB
SCALE	1/8"=1'-0"	19.0 SBT	SHEET 2







400 WAGB 0103-3

REV  
SHT  
ZONE  
ITEM

REV  
SHT  
ZONE  
ITEM

DWG NO  
400 WAGB 0103-3

SH

REV



AB

REVISIONS				DATE	APPROV
REV	SHT	ZONE	ITEM		

U.S. COAST GUARD HEADQUARTERS WASHINGTON, D.C. 20593			
NAVAL ENGINEERING DIVISION			
400' WAGB 0103-3			
BOOKLET OF GENERAL PLANS			
THIRD DECK & FIRST PLATFORM			
SIZE	FROM CASE NO	U.S.C.G. DRAWING NO.	REV
H 81340	400 WAGB 0103-3	AB	
SCALE	1/8"=1'-0"	19.6 SBT	SHEET 7 OF 10

SCALE FACTOR ELECTRONIC FILENAME  
96 \400WAGB\850103746.DWG



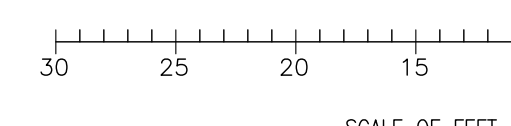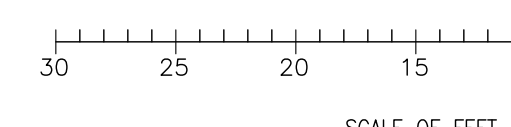




400 WAGB 0103-3  
DWG NO

H  
G  
F  
E  
D  
C  
B  
A


144 143 142 141 140 139 138 137 136 135 134 133 132 131 130 129

REV	SHT	ZONE	ITEM	REVISIONS		DATE	APPROV
				DESCRIPTION			


H  
G  
F  
E  
D  
C  
B  
A

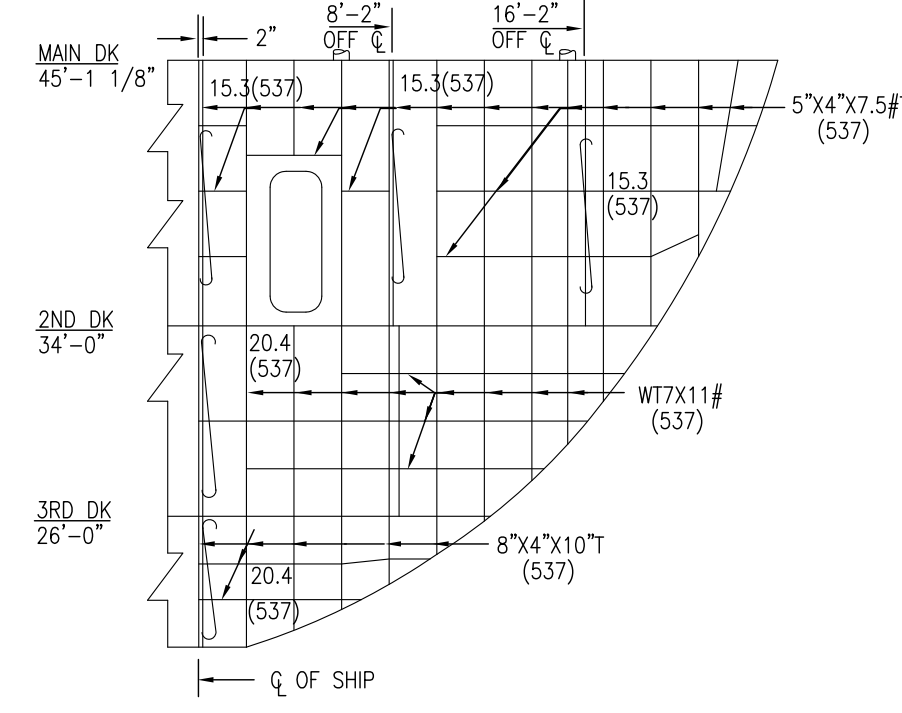


TRANSV OT & WT BHD FR 243  
PORT SIDE LKG AFT

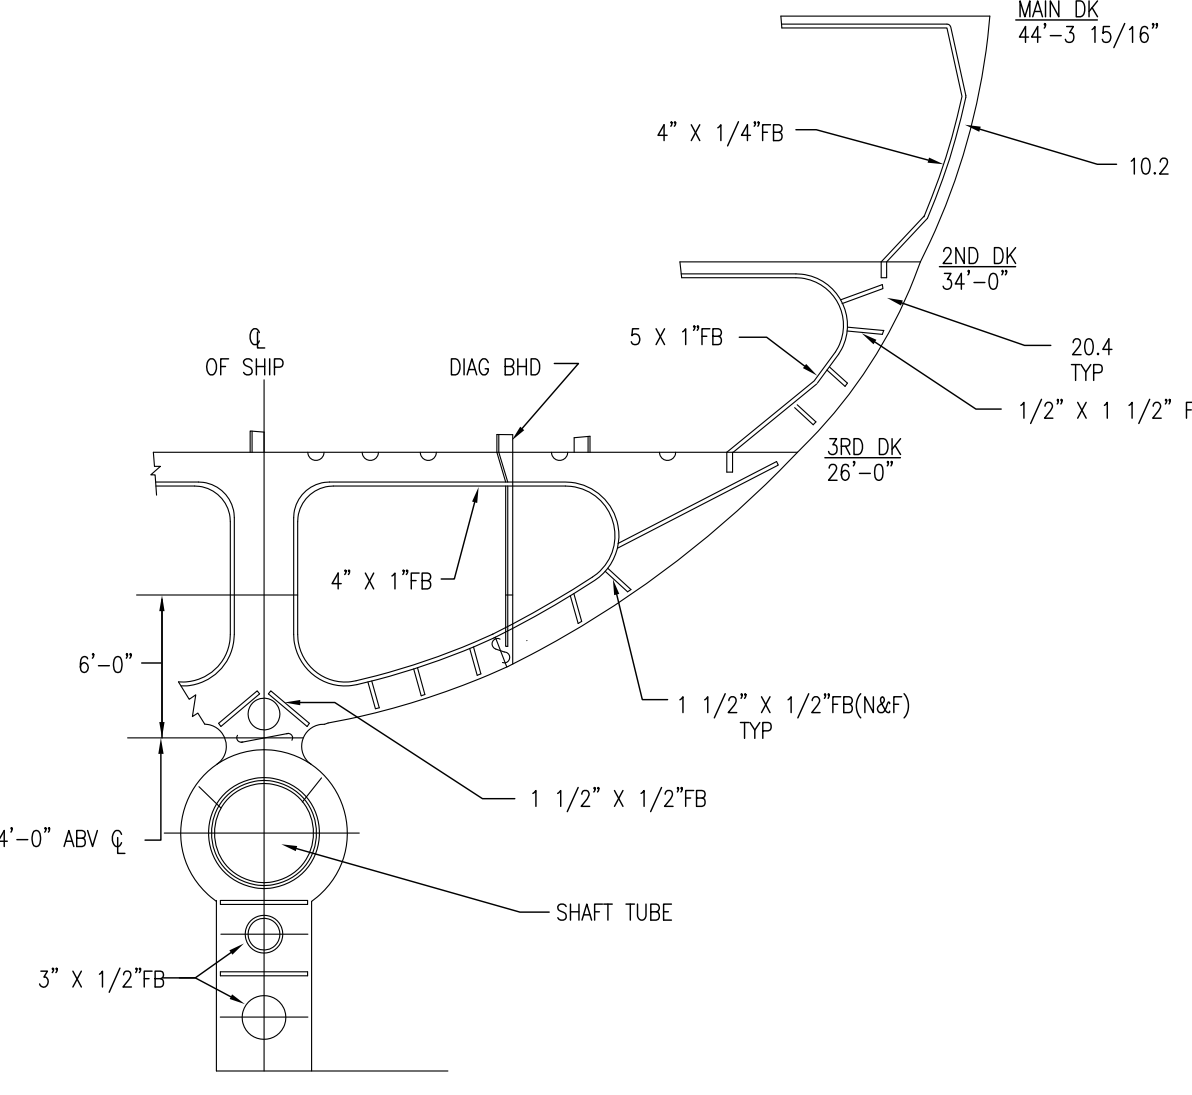


ICE FR 225  
PORT LKG AFT

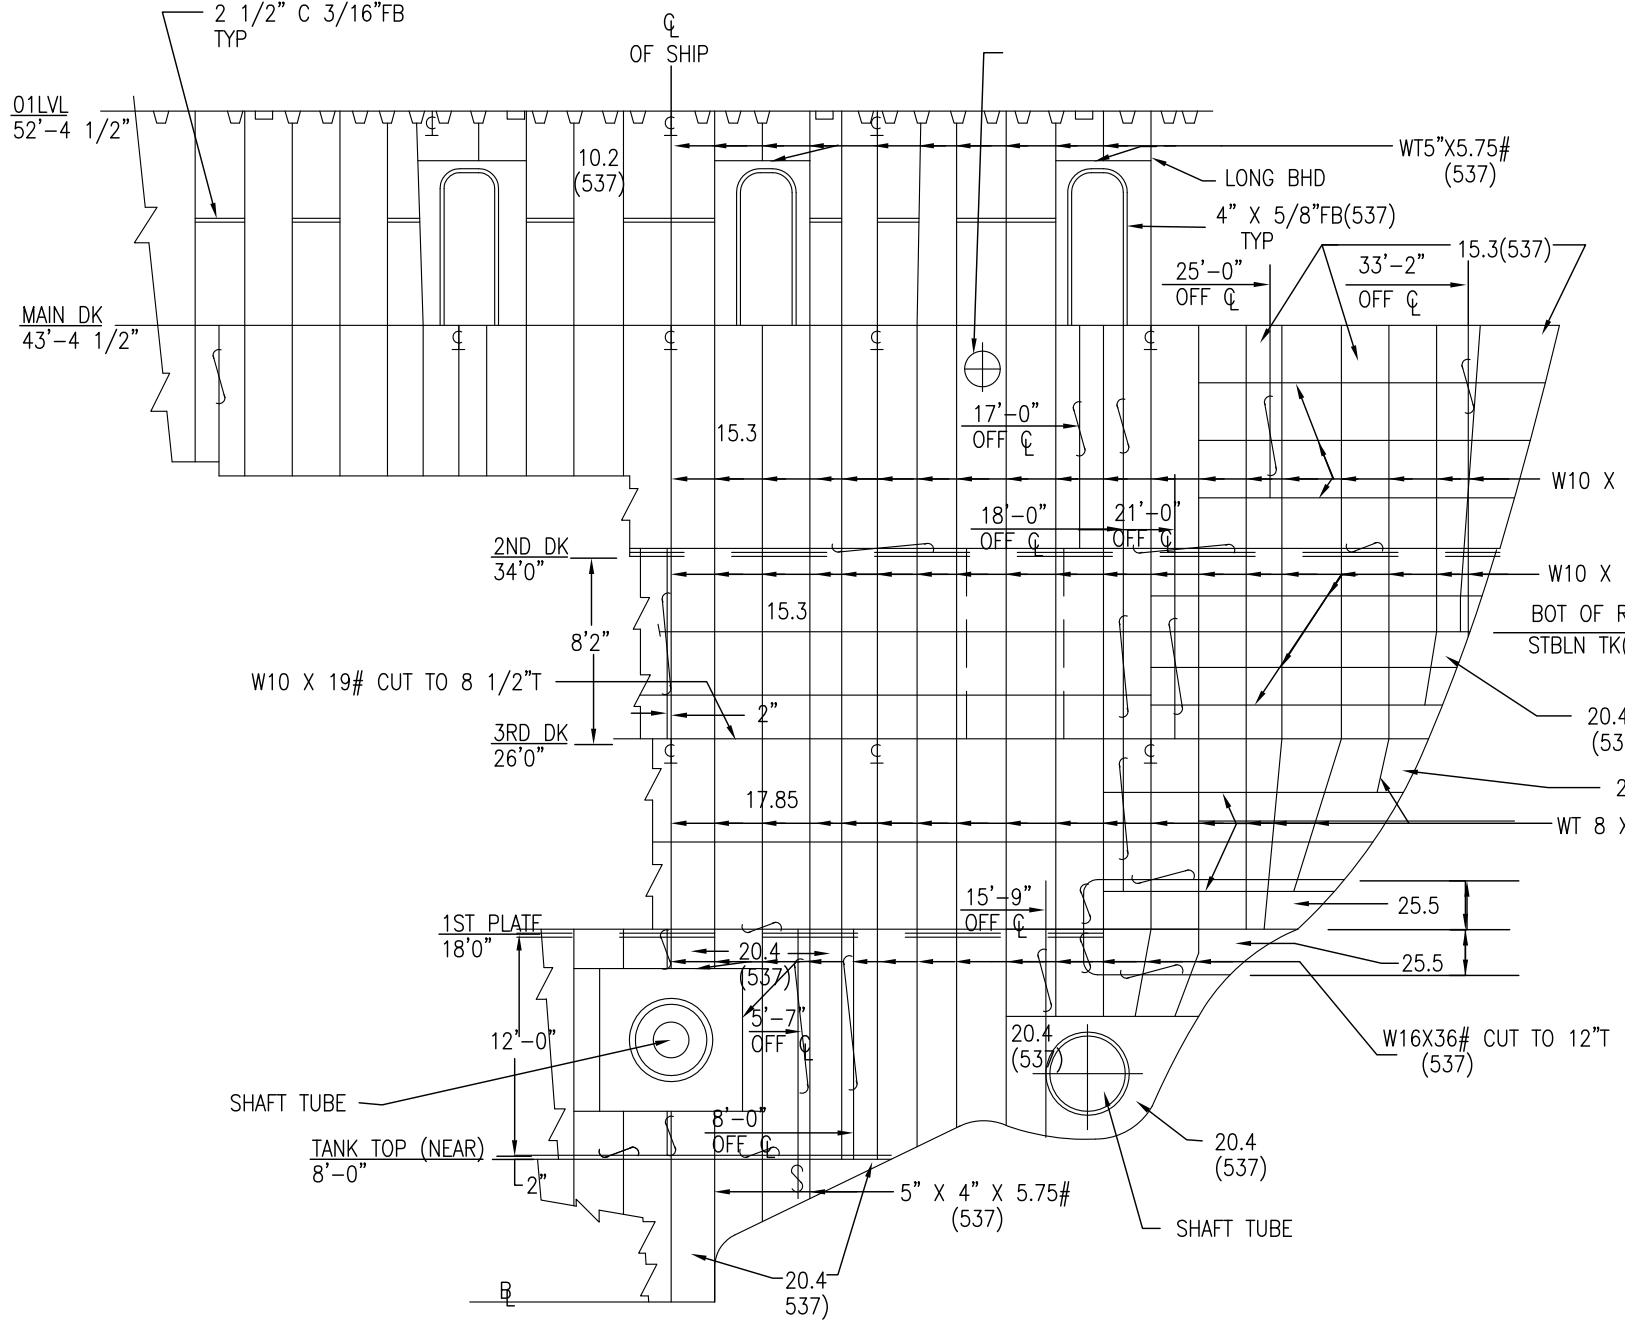

TRANSV OT, WT & NT BHD FR 197  
PORT LKG AFT

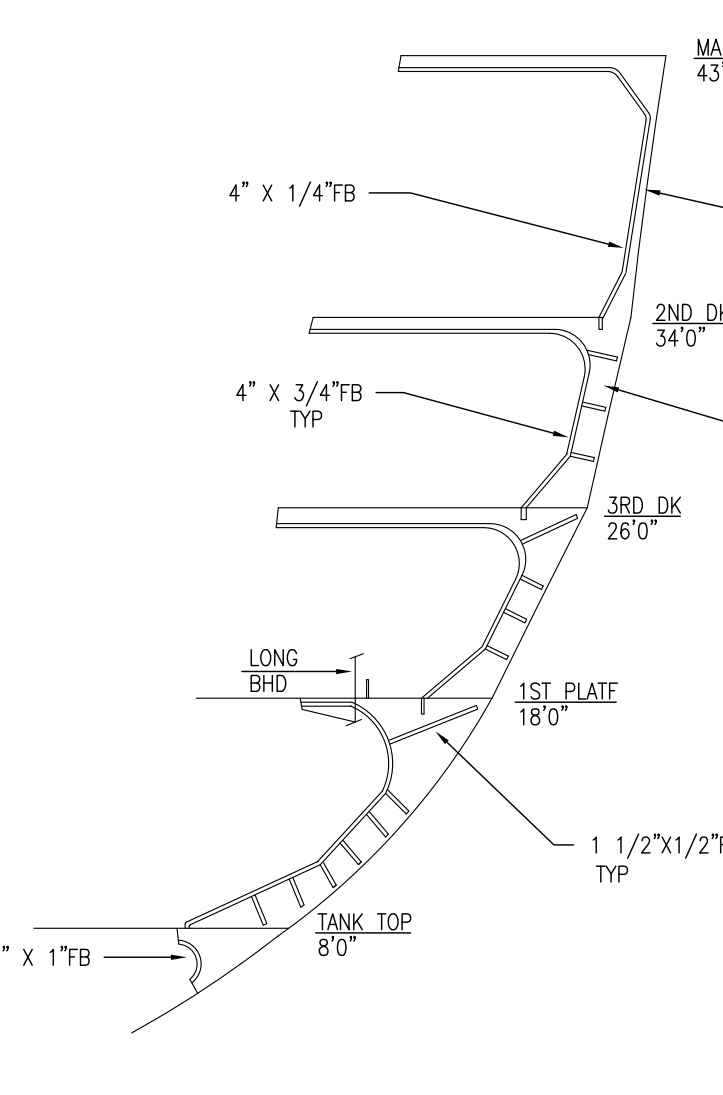


ICE FR 170  
PORT LKG AFT

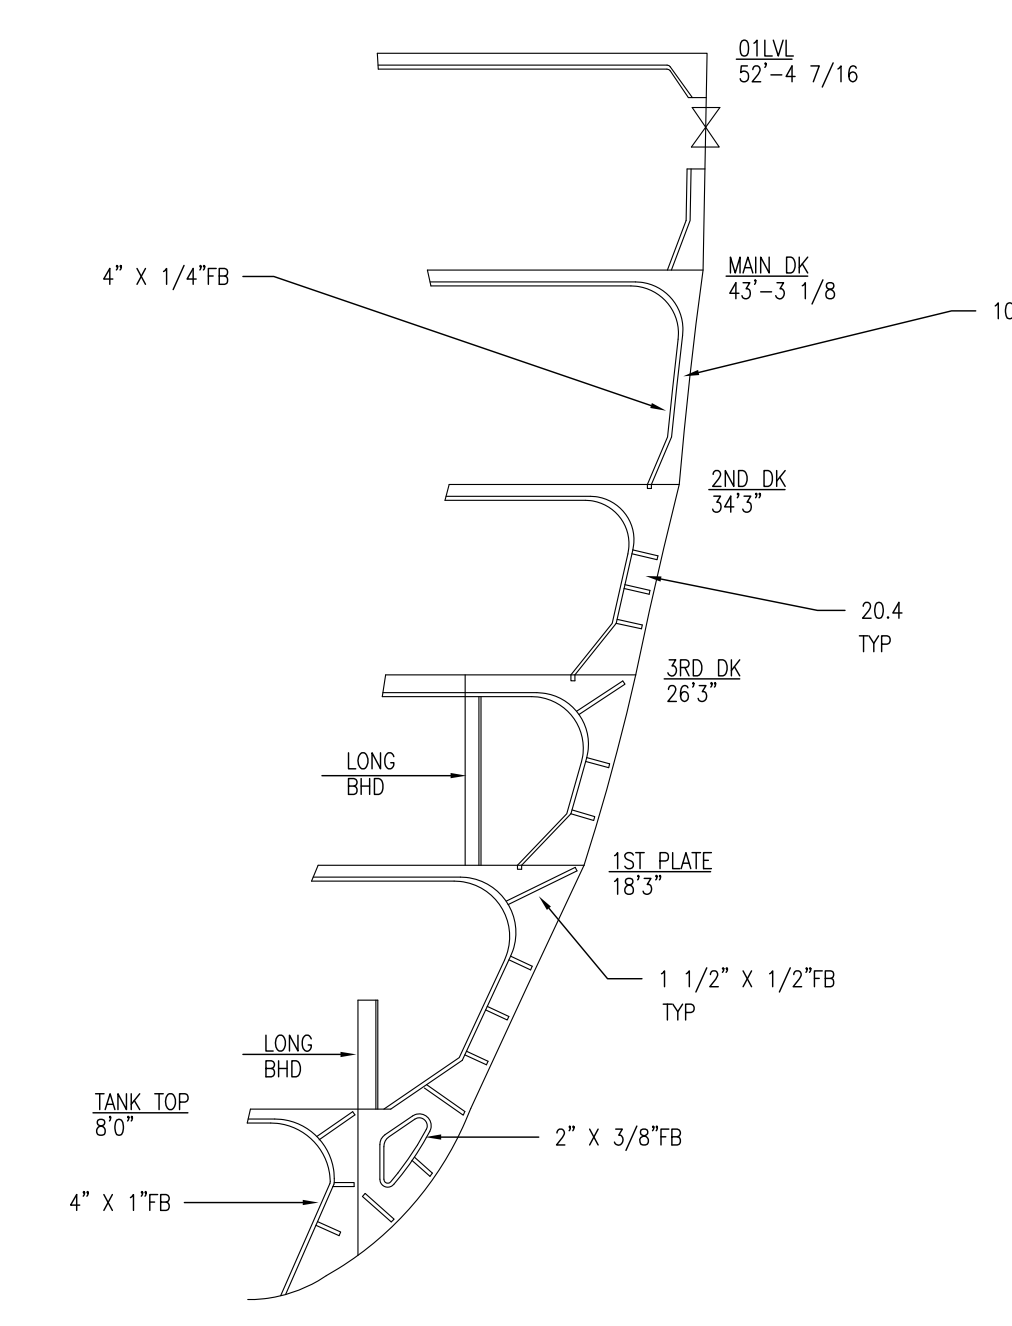


ICE FR 131  
STBD LKG FWD


TYPICAL SECTIONS  
400 WAGB 0103-3  
PLATE 15 OF 17

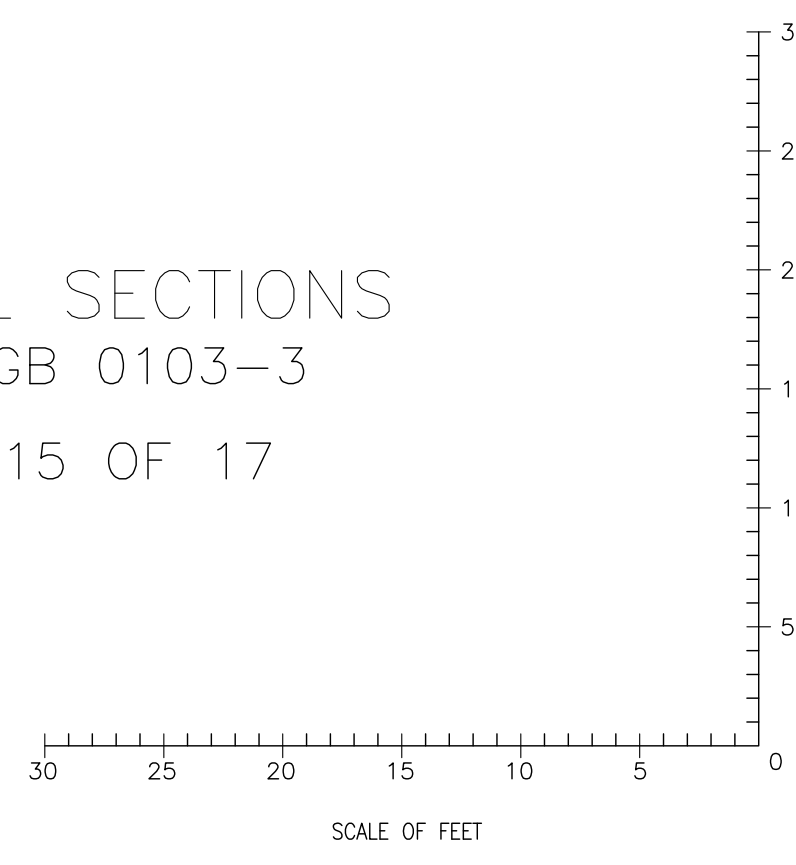


CUT LINE

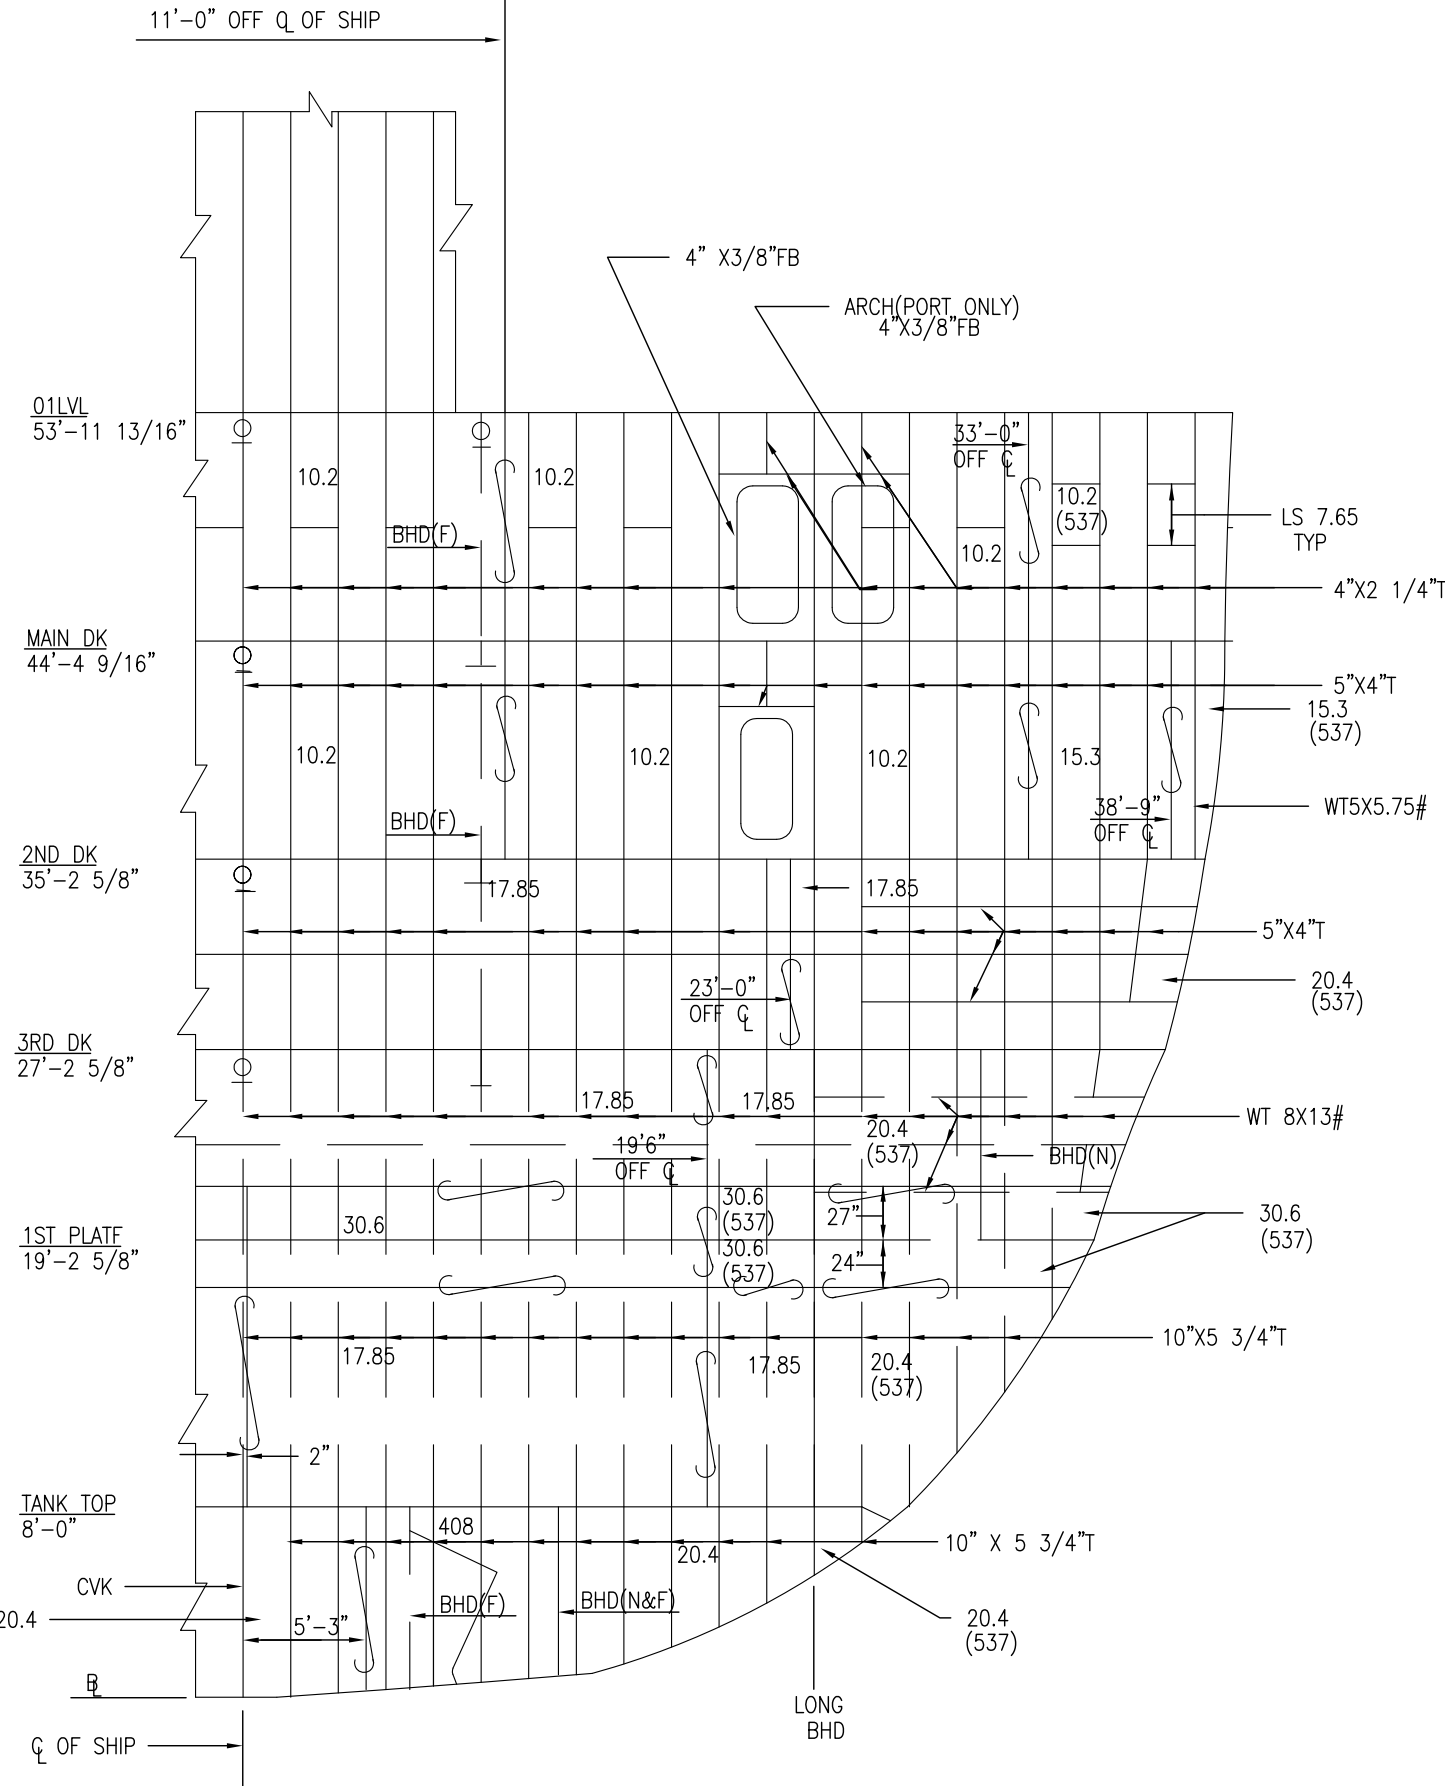


TRANSV BHD FR 85  
STBD SIDE LKG FWD

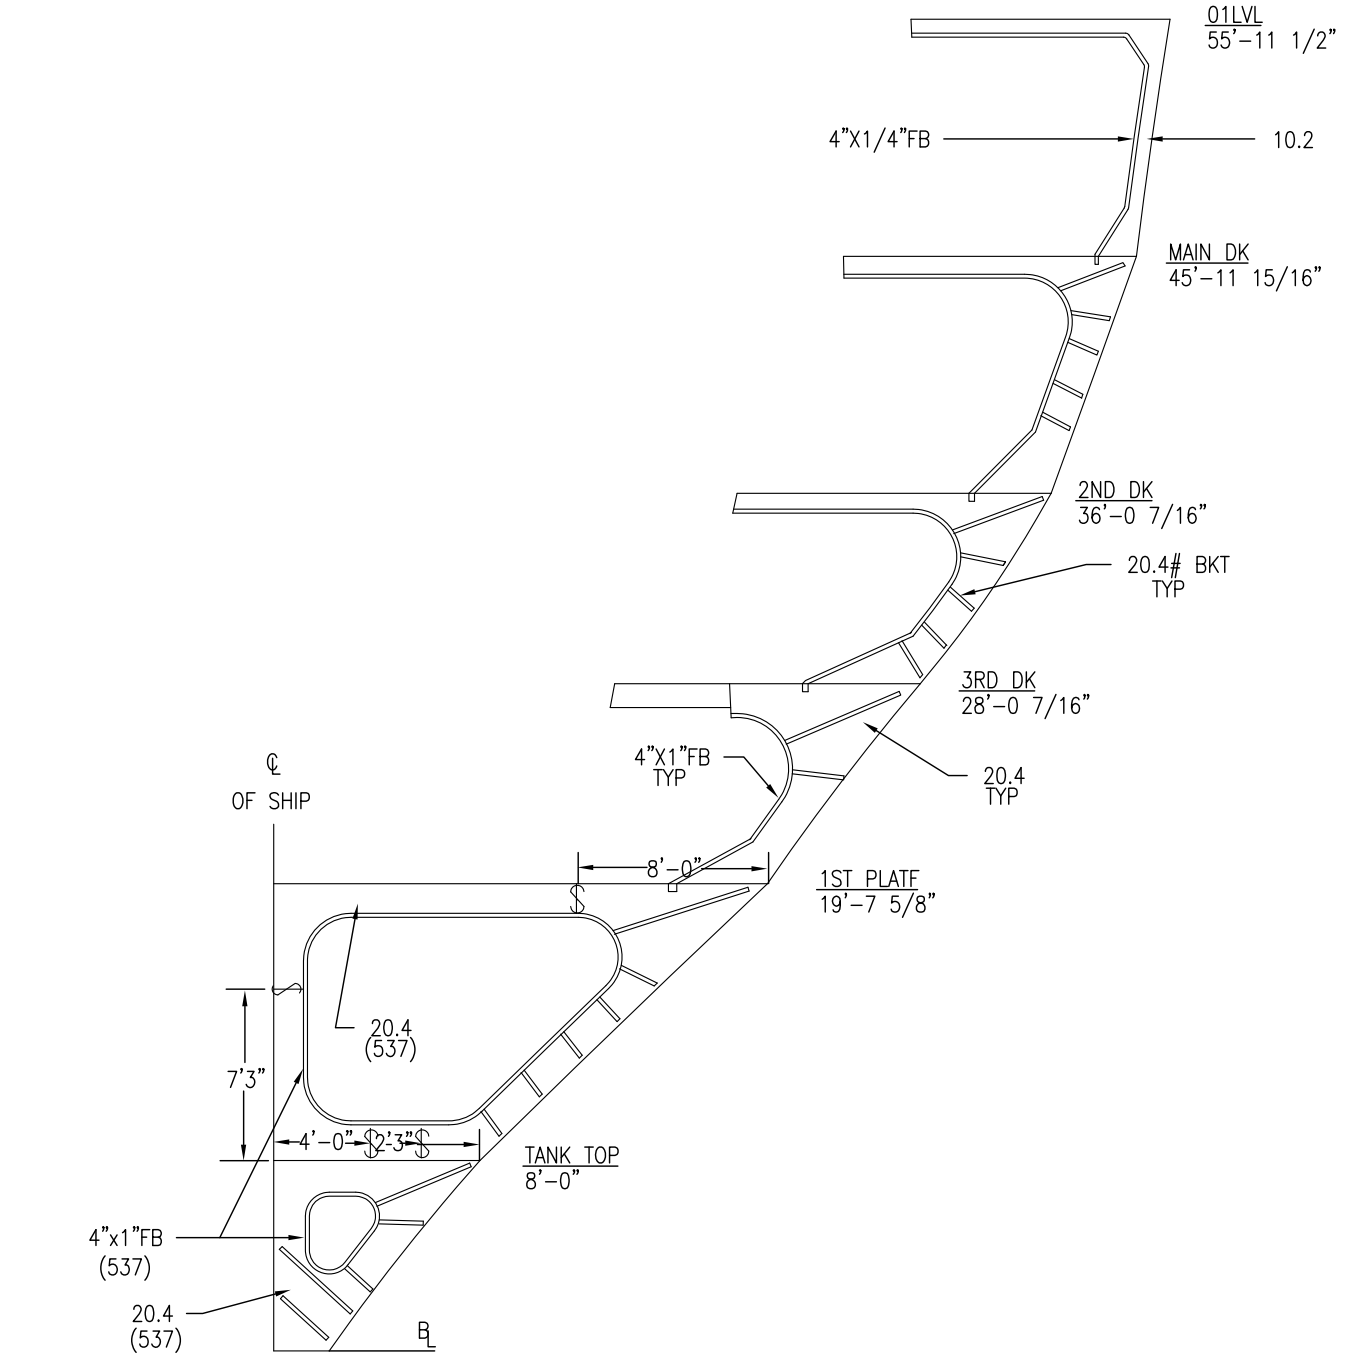


NT CANT FRAME 65  
STBD SIDE SHOWN LKG FWD

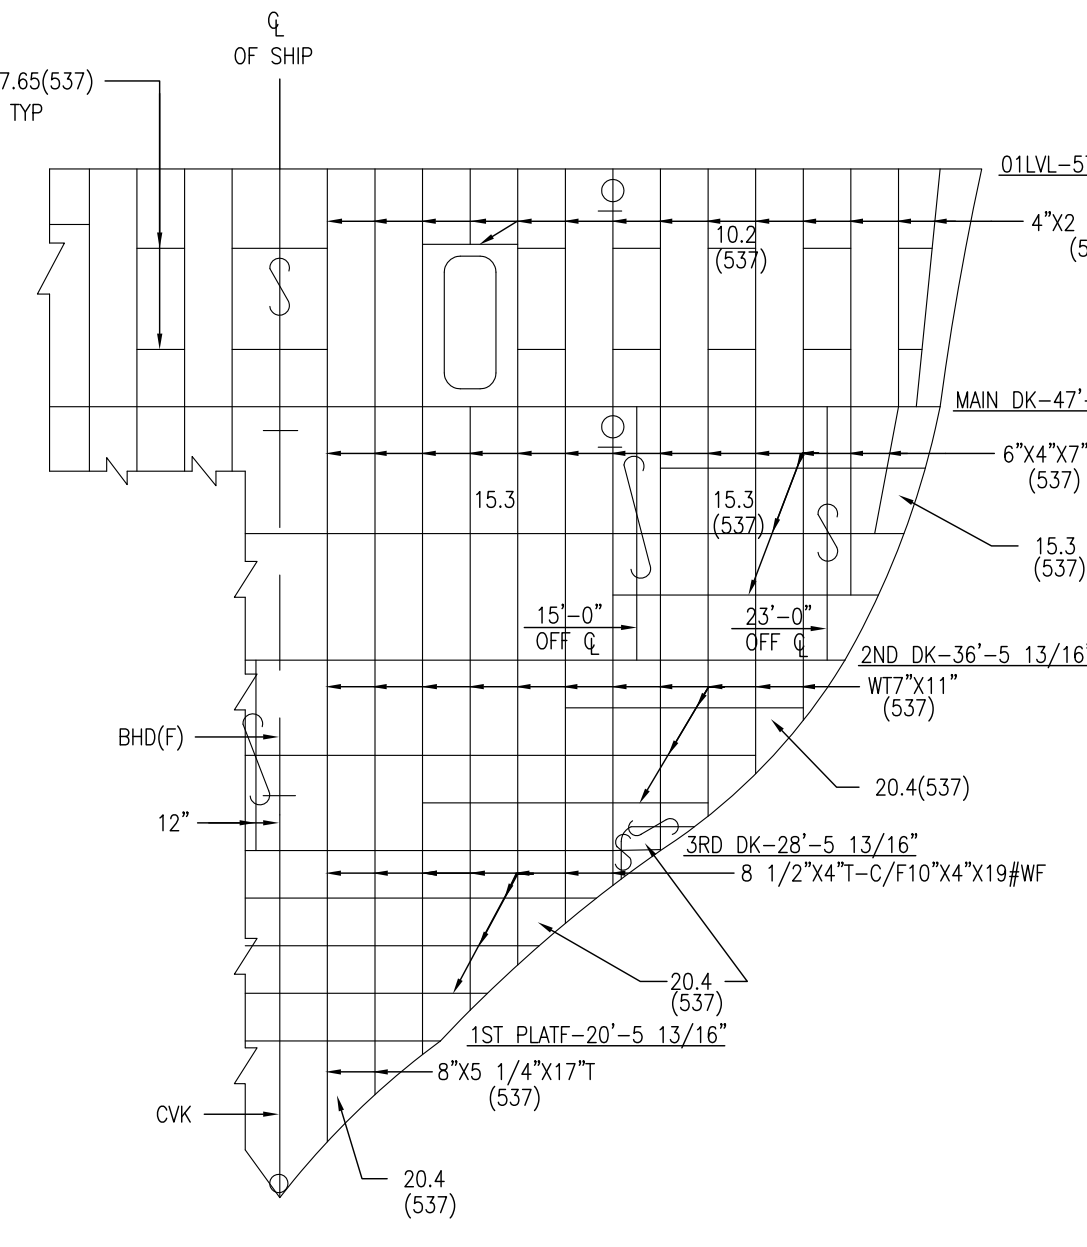

CANTED WT BHD CF-45  
STBD SIDE LKG FWD

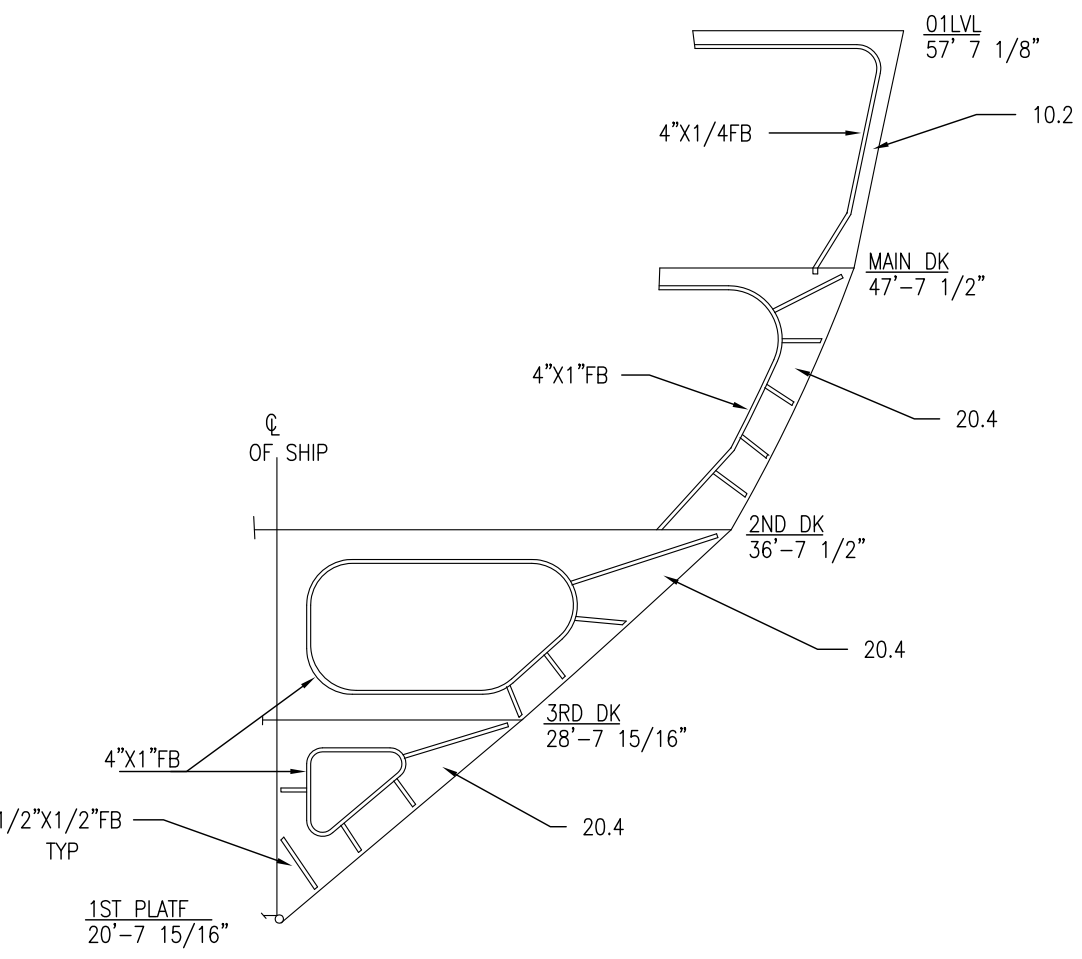


CF 37  
STBD LKG FWD

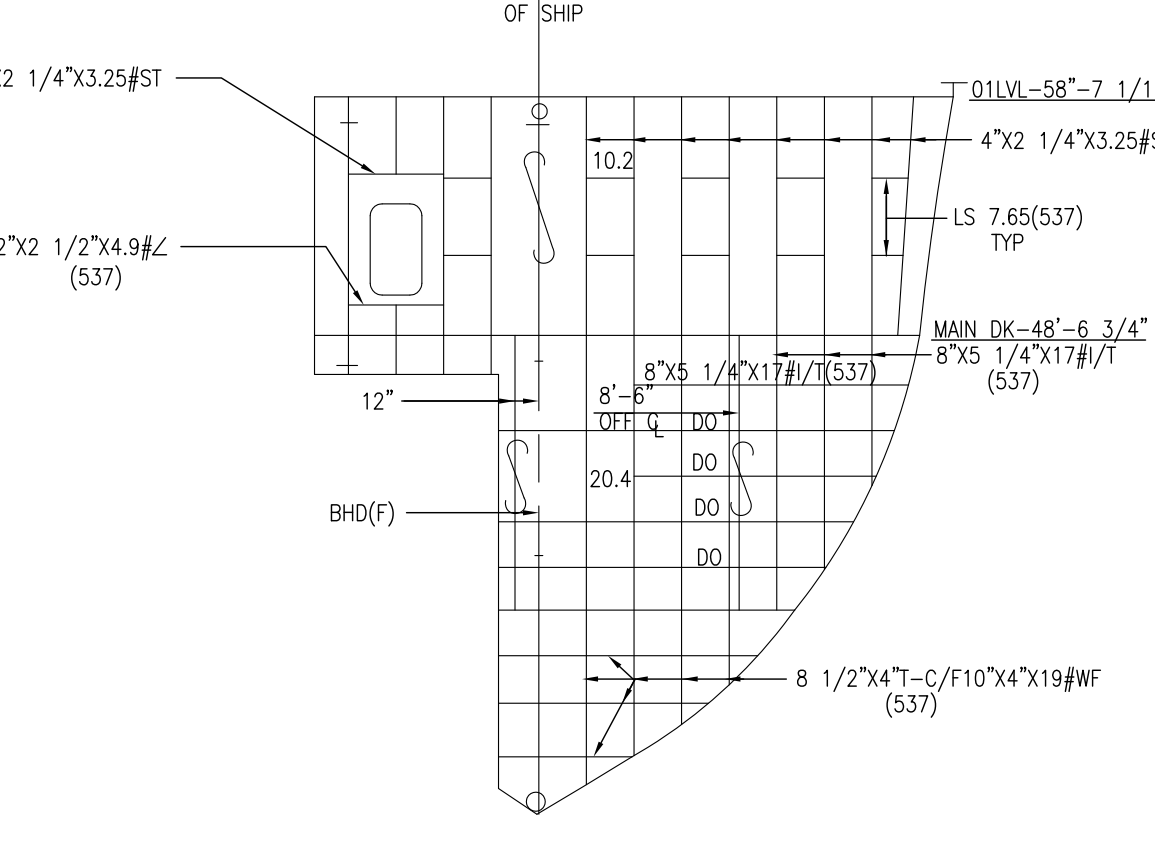

CANTED WT BHD CF-21  
STBD SIDE LKG FWD

TYPICAL SECTIONS  
400 WAGB 0103-3  
PLATE 16 OF 17

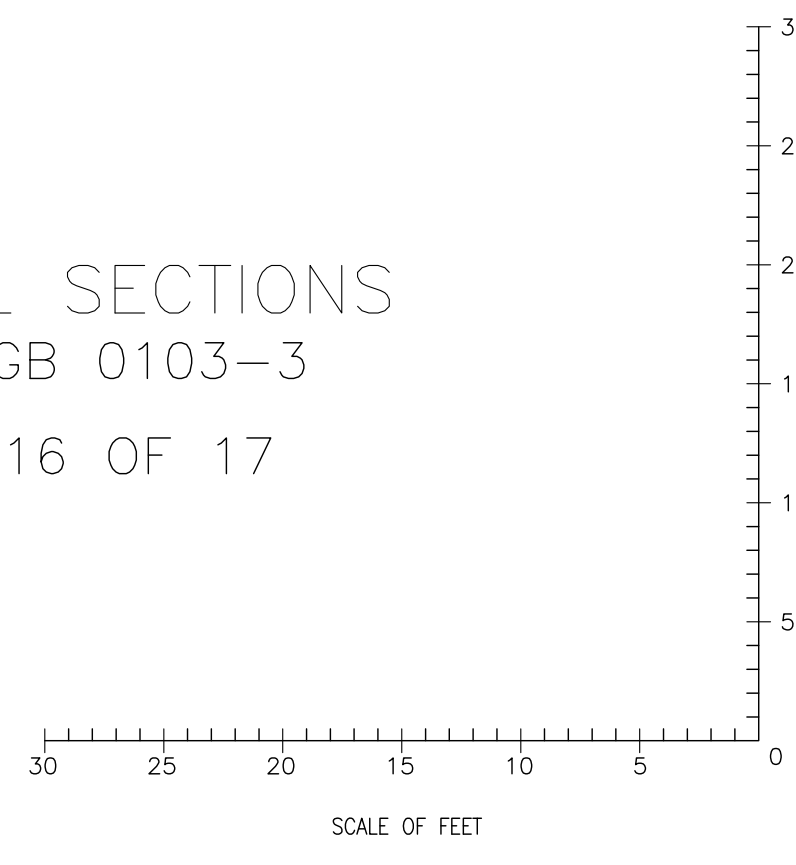

CUT LINE

DWG NO 400 WAGB 0103-3

SH 3


REV 1

U.S. COAST GUARD HEADQUARTERS WASHINGTON, D.C. 20593  
NAVAL ENGINEERING DIVISION  
400' WAGB  
BOOKLET OF GENERAL PLANS  
TYPICAL SECTIONS

SIZE	FROM CASE NO	U.S.C.G. DRAWING NO	REV
H	81340	400 WAGB 0103-3	N
SCALE	1/8"=1'-0"	19.8.2221	SHEET 9 OF 10

400 WAGB 0103-3  
DWG NO

 

145